

ILLEGIB

Approved For Release 2001/06/09 : CIA-RDP78T05439A000400230016-9

Approved For Release 2001/06/09 : CIA-RDP78T05439A000400230016-9

~~TOP SECRET RUFF~~

HANDLE VIA
TALENT-KEYHOLE
CONTROL SYSTEM ONLY


TCS No. 9204/64
TB No. 410/64
6 November 1964
Copy No. 1

MEMORANDUM FOR: Chief, Manufacturing and Service Division, ORR
ATTENTION :  25X1A
THROUGH : Chief, Requirements Branch, Reconnaissance Group, CGS
FROM : Chief, CIA/PID
SUBJECT : Rail Study of Communist China
REFERENCES : (1) Requirement No. C-RR4-81,487
(2) CIA/PID Project No. C 1021/64


1. This memorandum is in response to the referenced requirement concerning a railroad study of Communist China on the areas covered by AMS Map Sheets NL 44 and NL 45. This study is designed primarily for the purpose of determining the extent of new rail construction since 1960.

2. The study was based on information obtained from the following missions:

25X1D

 

3. All rail lines observed on the above referenced missions are plotted on the enclosed annotated overlays (CIA/PID/IB-P-1452/64 and CIA/PID/IB-P-1453/64). No new construction activity was noted. All abandoned construction is annotated on the enclosed overlays.

 4. The photo analyst assigned to this requirement was  who may be contacted on extension 2607 should there be any further questions regarding this study. This requirement is considered complete as of the date of this memorandum.

25X1A

25X1A

Declass Review by NIMA/DOD

ENCLOSURES:
2 Overlays (CIA/PID/IB-P-1452/64 thru P-1453/64)

GROUP 1
Excluded from automatic
downgrading and
declassification


~~TOP SECRET RUFF~~

HANDLE VIA
TALENT-KEYHOLE
CONTROL SYSTEM ONLY

15115

EDITION 1-AMS AMS NL 45 SERIES 130145
TCS 9204/64

SERIES 1301
SHEET NL 45
EDITION 1-AMS

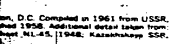

Scale: 1:1,000,000

TOP SECRET RUFF

9-61 PRINTED BY ARMY MAP SERVICE, CORPS OF ENGINEERS



LAMBERT CONFORMAL CONIC PROJECTION,



WORLD (ASIA) 1:1,000,000


TOP SECRET RUFF

CHENG-HUA

IB 410/84
EDITION 1-AMS AMS NL 45 SERIES 130/45
TCS 0204/44

SHEET 100
SHEET NO. 45
EDITION 1-AMS

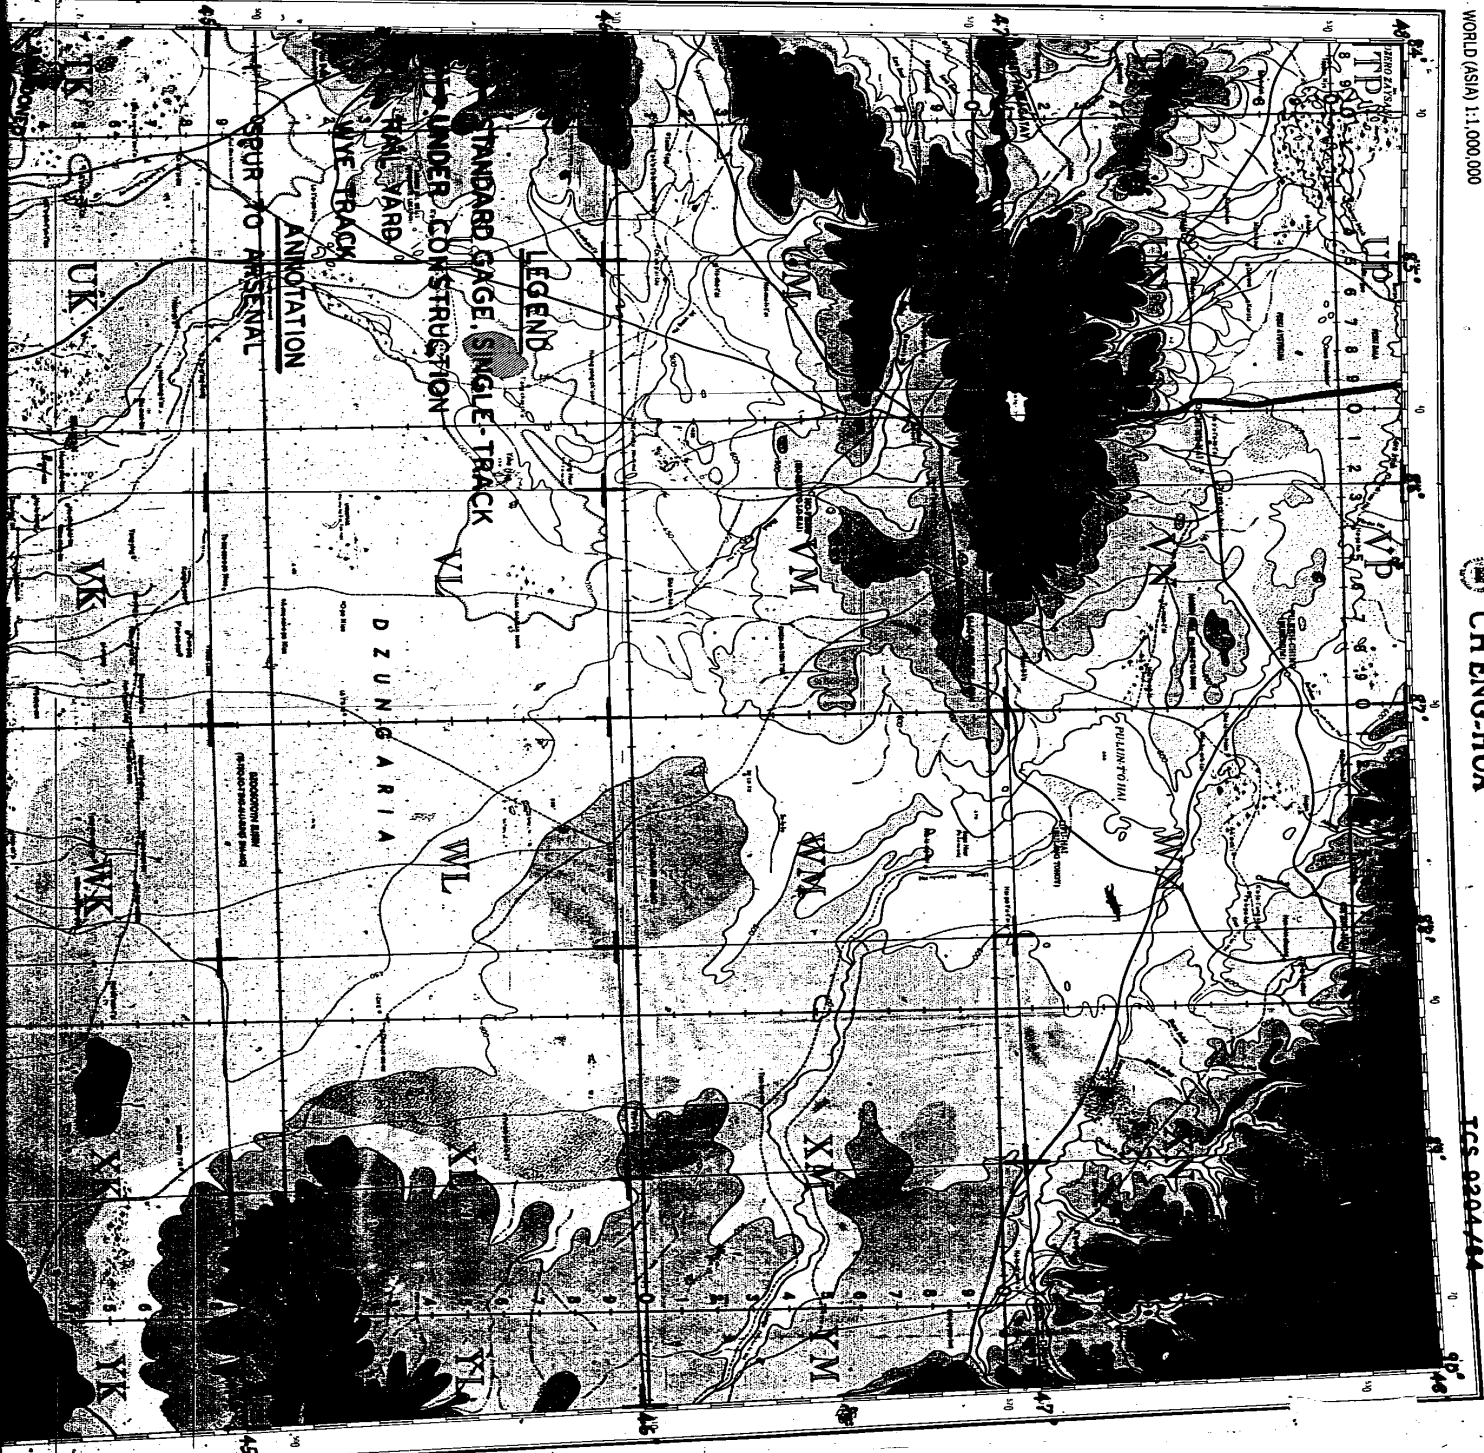

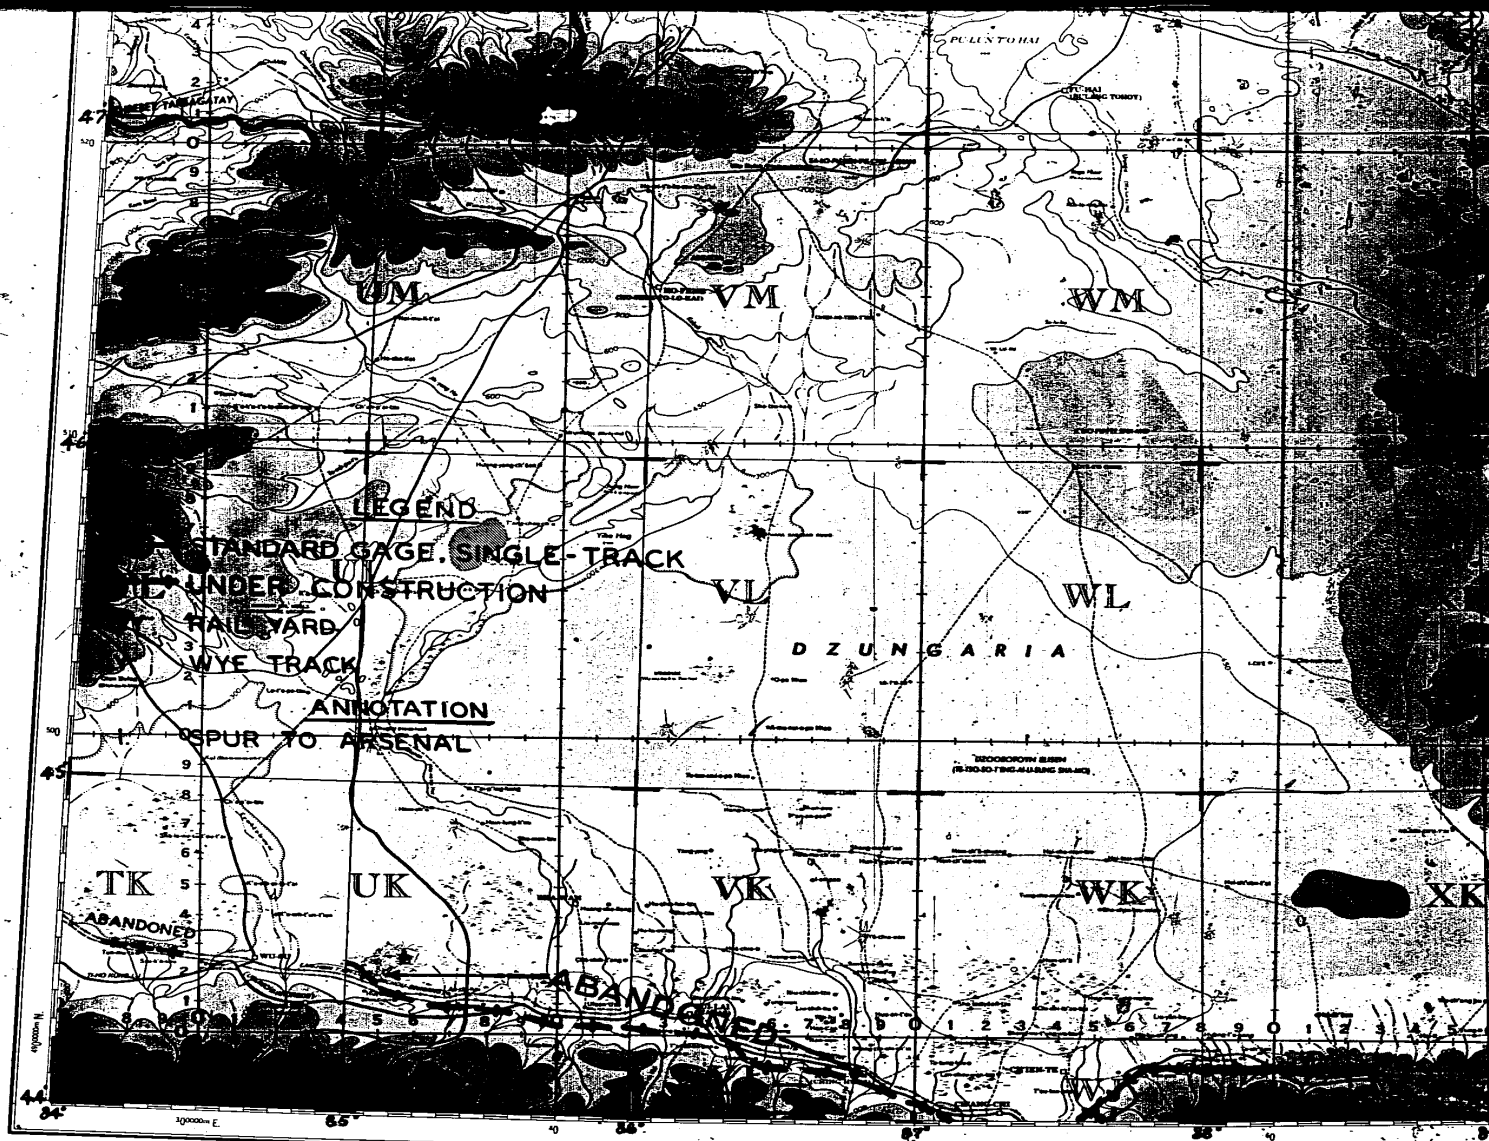

SERIES 1301

Edition 1-AMSdFirst Printing 9-61)

Prepared by the Army Map Service (PWS), Corps of Engineers, U. S. Army, Washington, D. C. Compiled in 1961 from USSR, 1:2,500,000, Chief Administration of Geodesy and Cartography; Sheet 14, published 1958. Additional detail taken from China Atlas, 1:1,000,000, Bureau of Survey, Ministry of National Defense, Sheet NL 45, 1948, Kazakhskaya SSR, 1:1,500,000, Chief Administration of Geodesy and Cartography, Sheet 2 of 4, 1958.

CIA/PID/IB-P-1453/64

TOP SECRET RUFF

LAMBERT CONFORMAL CONIC PROJECTION
STANDARD PARALLELS 44°40'N AND 63°30'N

PHOTOGRAPHED BY THE U.S. AIR FORCE PHOTOGRAPHIC CENTER, WRIGHT-PATTERSON AFB, OHIO.

HEIGHTS ARE IN METERS AND ARE REFERRED TO MEAN SEA LEVEL.

POPULATED PLACES

THE DELINEATION OF INTERNATIONAL
BOUNDARIES ON THIS MAP MUST NOT
BE CONSIDERED AUTHORITY

SERIES 1301
SHEET NL 45
EDITION 1-AWS

SERIES 1301
 Edition 1-AWS (Flight Printing, 9-61)
 Prepared by the Army Map Service (PM), Corps of Engineers, U.S. Army, Washington, D.C. Compiled in 1961 from USSR,
 1:250,000, 1:500,000, Administrative and Geodesic and Cartographic, Sheet 14, published 1958; Additional detailed data from
 China, 1:500,000, 1:1,000,000, Bureau of Survey, Ministry of National Defense, Sheet NL 45, 1948, Kazakhstan SSR,
 1:250,000, 1:500,000, Administrative of Geodesic and Cartography, Sheet 2 of 4, 1958.
 CIA/PID/IB-P-1453/64

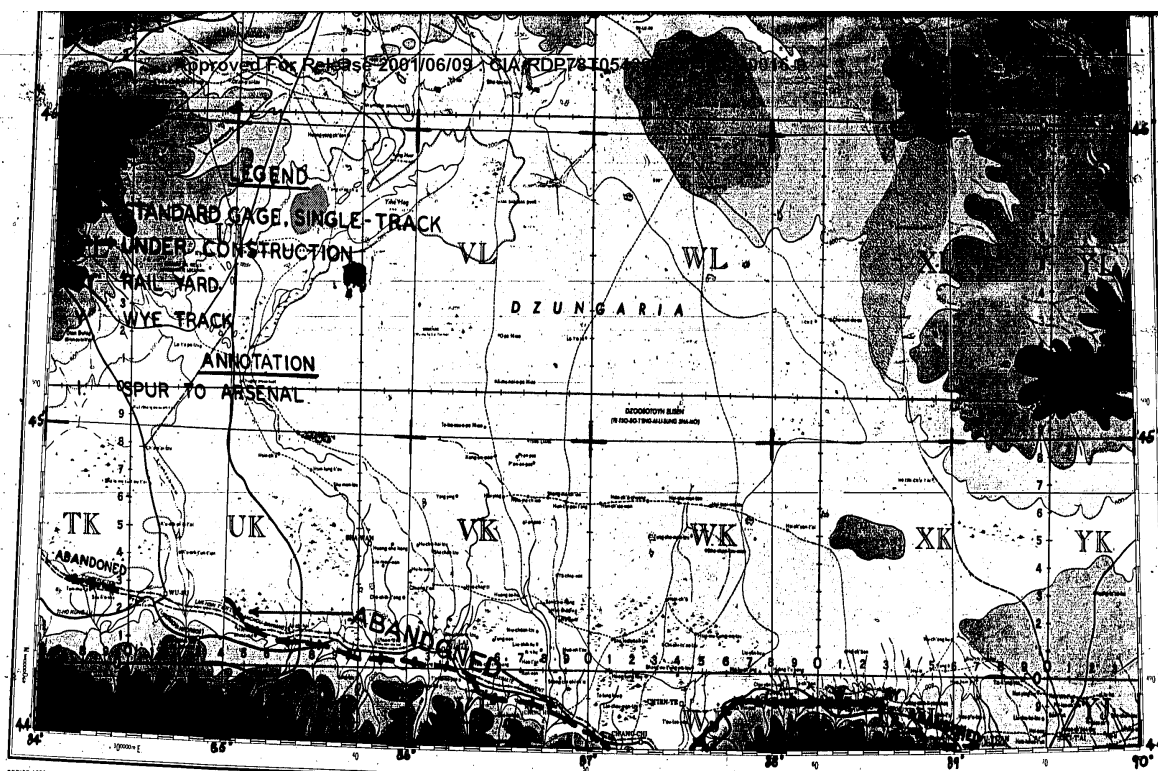

SERIES 1301
 Edition 1-AWS (Flight Printing, 9-61)
 Prepared by the Army Map Service (PM), Corps of Engineers, U.S. Army, Washington, D.C. Compiled in 1961 from USSR,
 1:250,000, 1:500,000, Administrative and Geodesic and Cartographic, Sheet 14, published 1958; Additional detailed data from
 China, 1:500,000, 1:1,000,000, Bureau of Survey, Ministry of National Defense, Sheet NL 45, 1948, Kazakhstan SSR,
 1:250,000, 1:500,000, Administrative of Geodesic and Cartography, Sheet 2 of 4, 1958.
 CIA/PID/IB-P-1453/64

[illegible]

Scale 1:1,000,000

10 30 50 70 90 100 Statute Miles

10 30 50 70 90 100 Kilometers

60 Nautical Miles

LAMBERT CONFORMAL CONIC PROJECTION
STANDARD PARALLELS 44°40'N AND 47°20'N
PLOT SCALE: 1:500,000
INTERPOLATED FROM 1:250,000 MAPS
INTERPOLATED FROM 1:250,000 MAPS

HEIGHTS ARE IN METERS AND ARE REFERRED TO MEAN SEA LEVEL

RELIABILITY DIAGRAM INDEX TO ADJOINING SHEETS INDEX TO BOUNDARIES

[illegible]

		SL 44	SL 45	SL 46		R CCHuk	Gara Hig Hing Sen
--	--	-------	-------	-------	--	------------	----------------------------

[illegible]


[illegible]

100-443887-100

THE DELINEATED
BOUNDARIES OF
THE COUNTRY

USERS NOTING ERRORS OR OMISSIONS ON THIS MAP ARE URGED TO MARK HEREON AND FORWARD DIRECTLY TO COMMANDING OFFICER, ARMY MAP SERVICE, WASHINGTON, D.C. MAPS SO FORWARDED WILL BE PROMPTLY FORWARDED TO THE OFFICE OF THE CHIEF OF MAPS, ARMY, WASHINGTON, D.C.

2004106100 - CIA RRR78T05432 - 00032004100

2001/06/09 : CIA-RDP78105439A000400230016-9

100

D-41 PRINTED BY ARMY MAP SERVICE, CORPS OF ENGINEERS

100


[illegible]

1	2	
---	---	---	---	---	---	---	---	---	----	----	-----

1	2	
1	2	

114

EXPLANATORY NOTES

well 2 BOUNDARIES
valley CHINA (MONTGOMERY)
sands * Boundary is indefinite

POPULATED PLACES IN CHINA

range	RAILROADS	
highway	Normal gauge	
mountain	in China ——— 4 865 (3 44 m)	
Amur		

ROADS
CHINA-MONGOLIA
Main road — generally loose surface
graded, all weather

Secondary road and other road	generally loose surface dry weather
road	not road

Secondary road — loose surface or improved dirt
Other road — dirt

ON OF INTERNATIONAL
IN THIS MAP MUST NOT
BE DETERMINATIVE

CH'ENG-HUA, CHINA; MONGOLIA; U.S.S.R.

TOP SECRET RUFF
PANFILOV

EDITION 2-AMS


AMS NL 44 SERIES 1301

TCS 9204/64

IB 410/64

NL 44
SERIES 1301

SHEET NL 44
EDITION 2-AMS

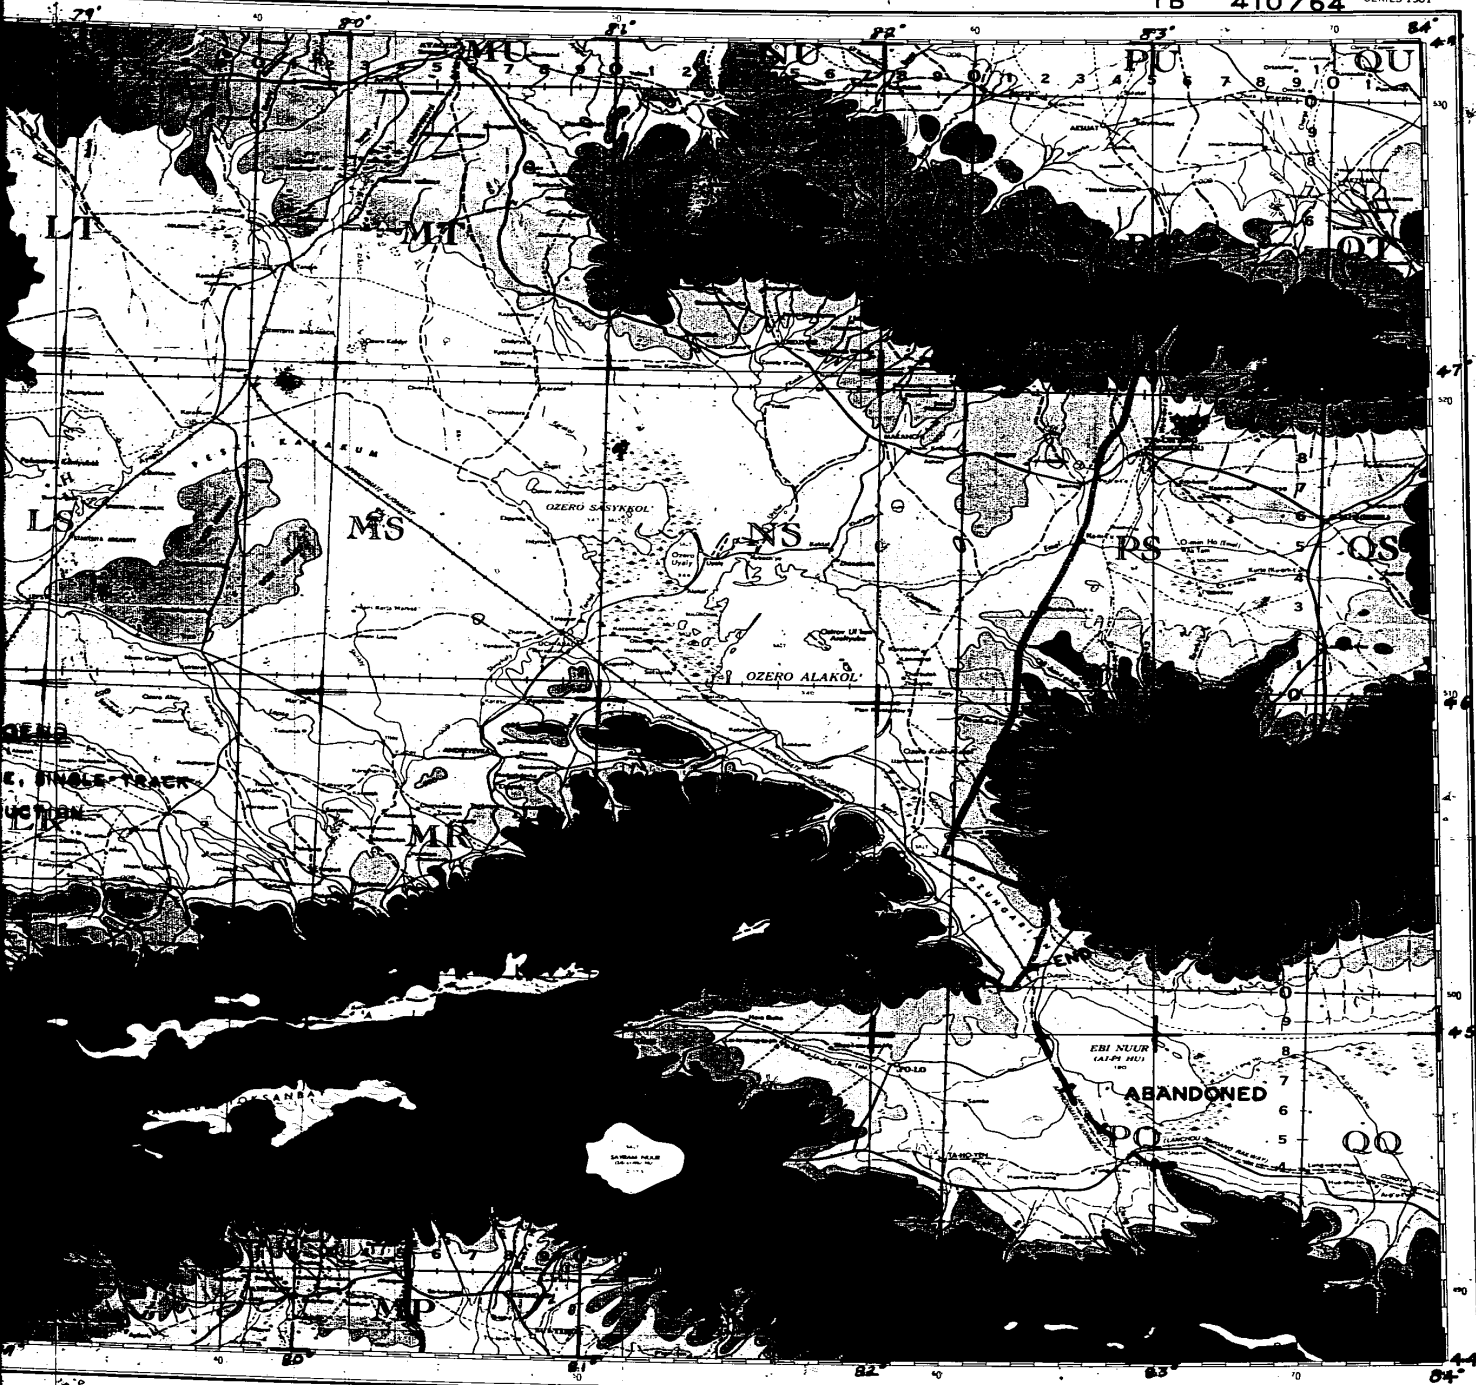

2/64

Scale 1:1,000,000
TOP SECRET RUFF

8 62 PRINTED BY ARMY MAP SERVICE, CORPS OF ENGINEERS

Approved For Release 2001/06/09 : CIA-RDP78T05439A000400230016-9

TOP SECRET RUFF


PANFILOV

AMS NL 44 SERIES 130

TCS 9204/64
IB 410/64

EDITION 3-AMS

WORLD (ASIA) 1:1,000,000

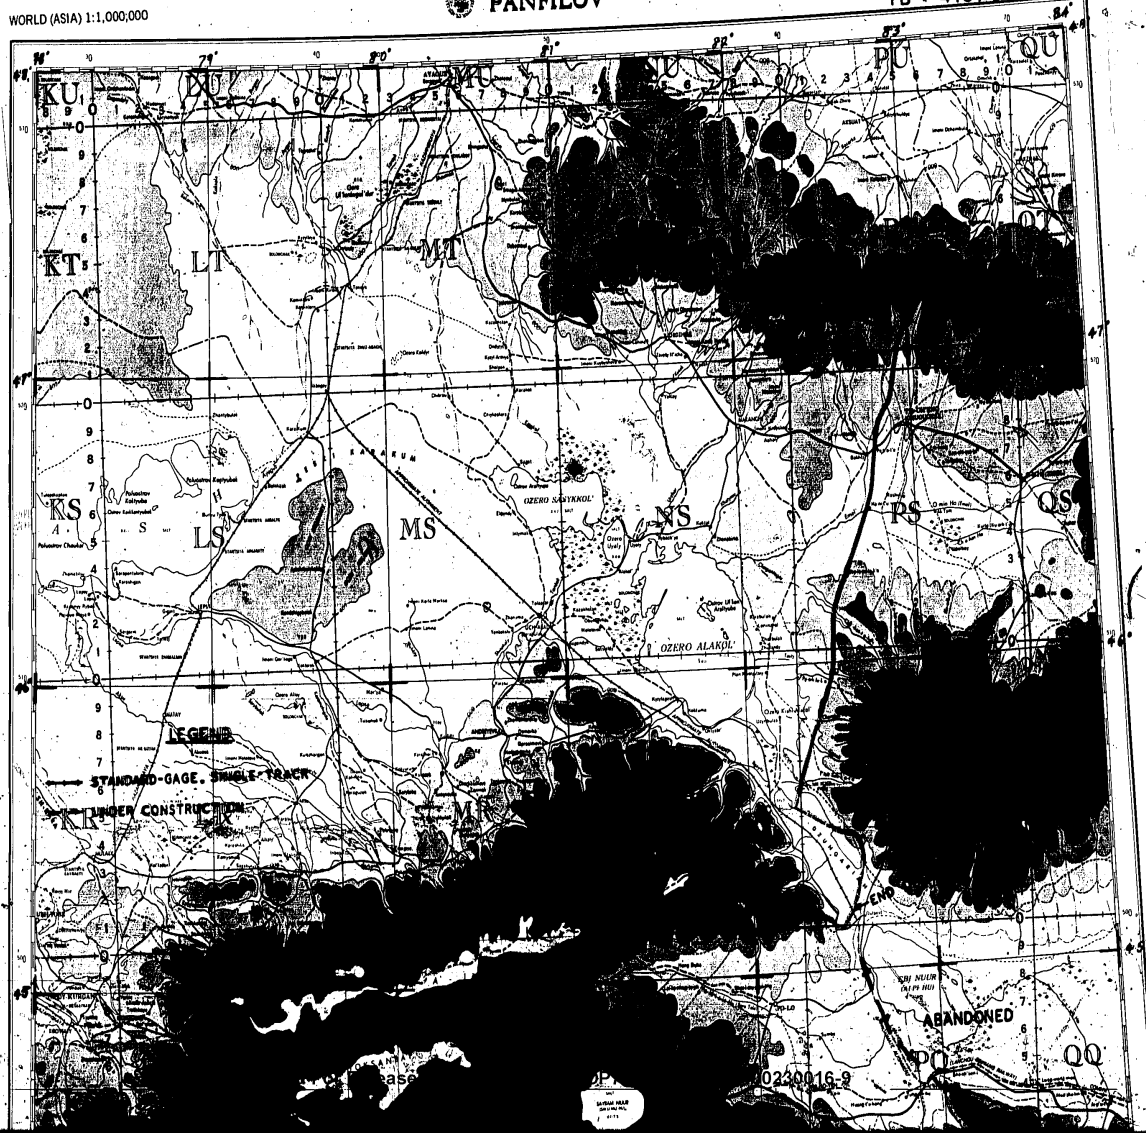




1301
 Edition 2 AMB (First Printing, 8 62)
 Prepared by the Army Map Service, U.S. Army
 Washington, D.C.
 Kazakhstani 5
 Geography, edition 1955, Pami-Ten-Shan, 1:1,500,000, Chief Administration
 of Geodesy and Cartography, printed 1952; Artyk-Sayan, 1:1,500,000, Chief
 Administration of Geodesy and Cartography, compiled 1954

Scale 1:1,500,000
 10 20 30 40 50 60 70 80 90 100 Statute Miles
 10 20 30 40 50 60 70 80 90 100 Nautical Miles
TOP SECRET RUFF

POPULATED PLACES		LEGEND	
U.S.S.R.	CHINA	RAILROADS	ALMA-ATA
100,000 or over	Capital, 100,000 or over	Standard-gauge, single-track	BALKHASH
50,000 to 100,000	Other cities, 50,000 or over	Under construction	PANFILOV
10,000 to 50,000	Other cities, 10,000 or over		WATERS
2,000 to 10,000	Other cities, 2,000 or over		
Less than 2,000	Other cities, less than 2,000		
RAILROADS		ROADS	

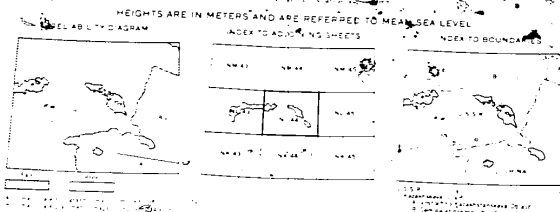

GLOSSARY		EXPLANATORY	

